




(A) (B) (D) (E) (F) (G) (H) (J) (K) (L)

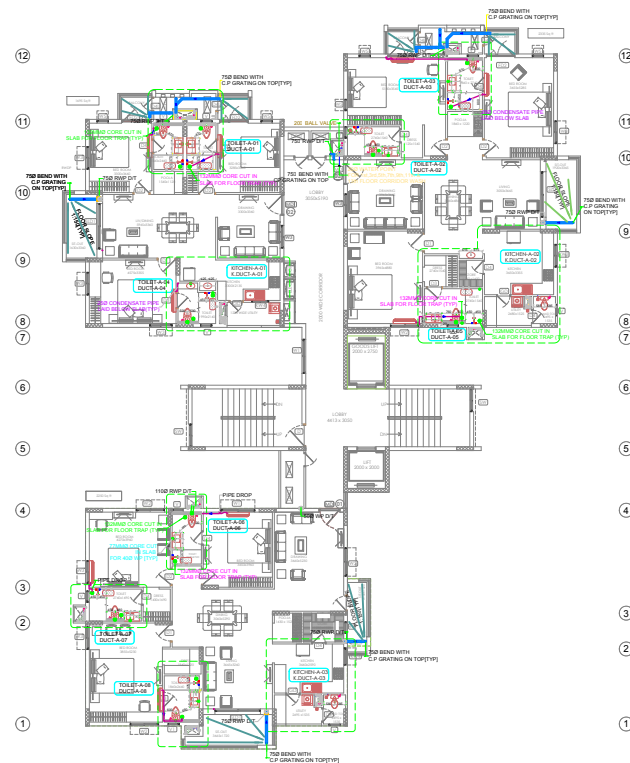

(A) (B) (D) (E) (F) (G) (H) (J) (K) (L)

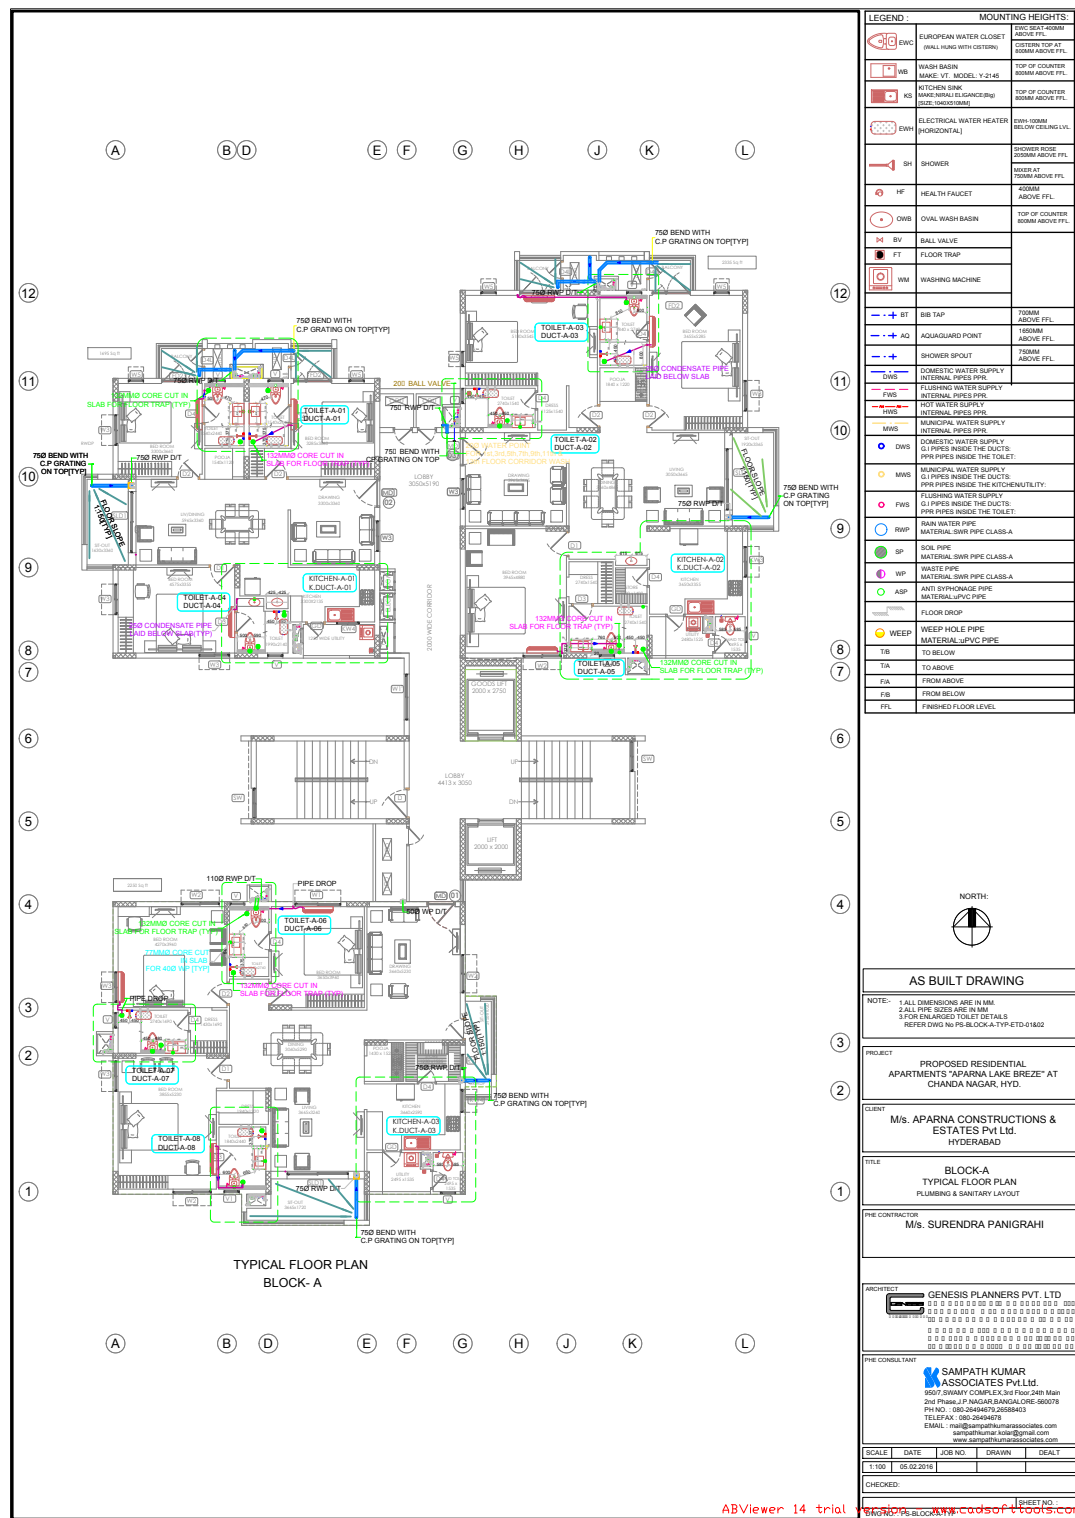

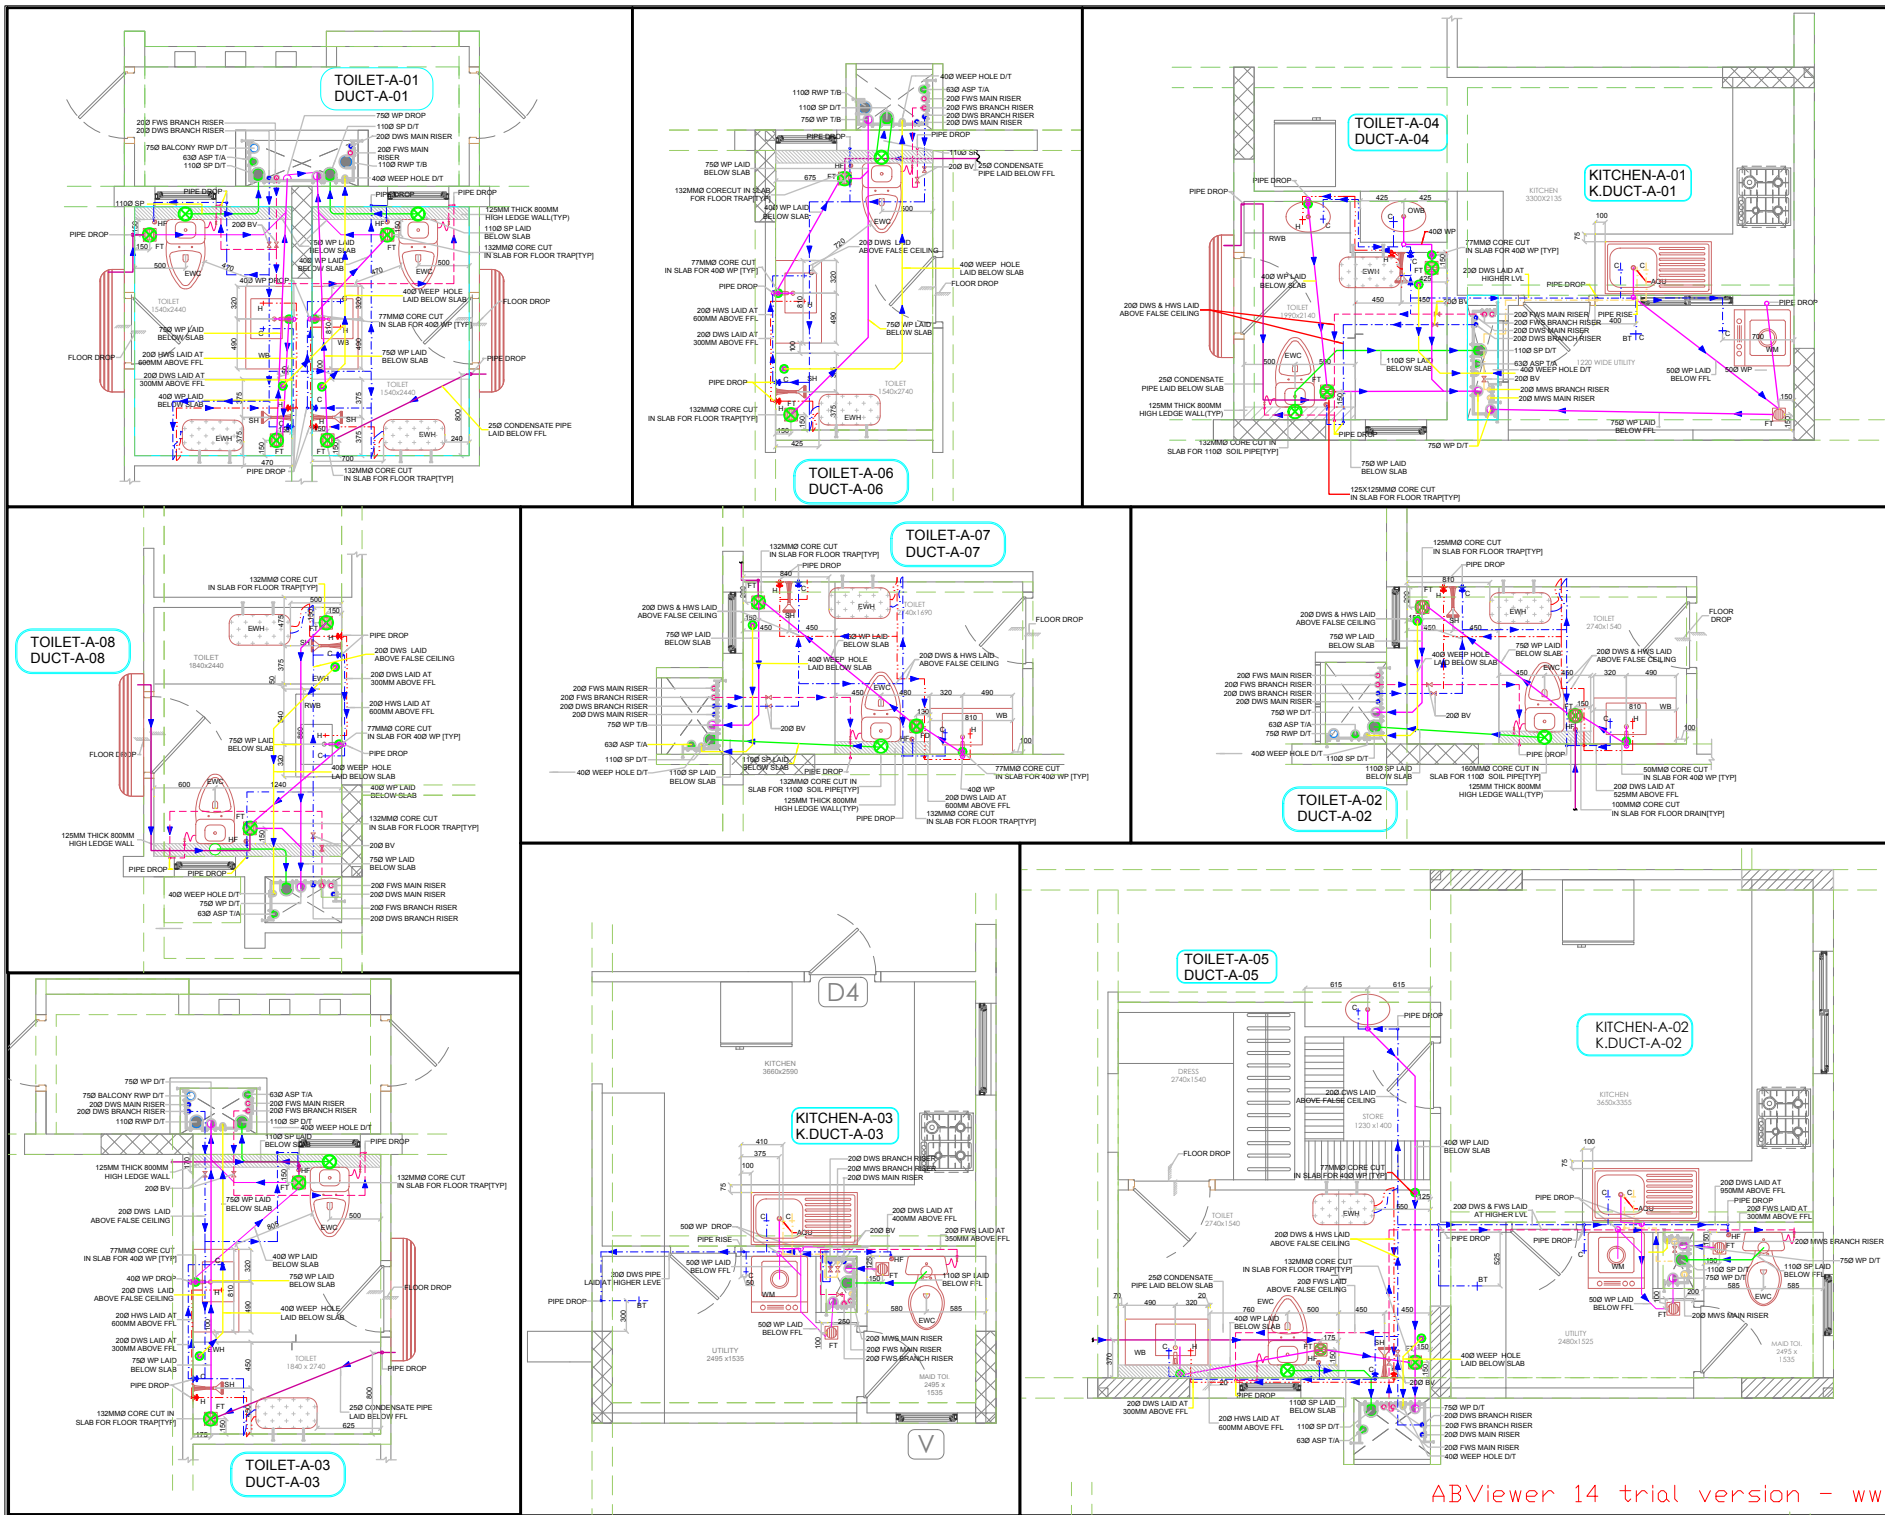

LEGEND :		MOUNTING HEIGHTS:	
	EWC	EUROPEAN WATER CLOSET (WALL HUNG WITH CISTERN)	EWV SEAT-200MM ABOVE FFL
	WB	WASH BASIN MAKE-UP MODEL Y-2145	CISTERN TOP AT 80MM ABOVE FFL
	KS	KITCHEN SINK MAKE-UPRAIL ELEVANCE (R) (SIZE: 1040X350MM)	TOP OF COUNTER 80MM ABOVE FFL
	EWH	ELECTRICAL WATER HEATER [HORIZONTAL]	EWV 100MM BELOW CEILING LVL
	SH	SHOWER	SHOWER ROSE 200MM ABOVE FFL
	HF	HEALTH FAUCET	400MM ABOVE FFL
	BV	BALL VALVE	100MM ABOVE FFL
	FT	FLOOR TRAP	750MM ABOVE FFL
	WM	WASHING MACHINE	100MM ABOVE FFL
	BT	BIT TAP	750MM ABOVE FFL
	AQ	AQUAQUAD POINT	160MM ABOVE FFL
	SS	SHOWER SPOUT	750MM ABOVE FFL
	FWS	DOMESTIC WATER SUPPLY INTERNAL PIPES	
	WWS	FLUSHING WATER SUPPLY INTERNAL PIPES	
	HWS	HOT WATER SUPPLY INTERNAL PIPES	
	MWS	MUNICIPAL WATER SUPPLY INTERNAL PIPES	
	DWS	DOMESTIC WATER SUPPLY G.I. PIPES INSIDE THE TOILET	
	MWS	MUNICIPAL WATER SUPPLY G.I. PIPES INSIDE THE TOILET	
	FWS	FLUSHING WATER SUPPLY G.I. PIPES INSIDE THE TOILET	
	WWS	WASHING WATER SUPPLY G.I. PIPES INSIDE THE TOILET	
	HWS	HOT WATER SUPPLY G.I. PIPES INSIDE THE TOILET	
	MWS	MUNICIPAL WATER SUPPLY G.I. PIPES INSIDE THE TOILET	
	SP	SOIL PIPE MATERIAL SWR PIPE CLASS-A	
	WB	WASTE PIPE MATERIAL SWR PIPE CLASS-A	
	ASP	ANTI SYPHONAGE PIPE MATERIAL UPVC PIPE	
	FD	FLOOR DROP	
	WH	WEEP HOLE PIPE MATERIAL UPVC PIPE	
	TIA	TO ABOVE	
	FIA	FROM ABOVE	
	FIB	FROM BELOW	
	FFL	FINISHED FLOOR LEVEL	
<p>NORTH</p> <p>AS BUILT DRAWING</p> <p>NOTE:- 1. ALL DIMENSIONS ARE IN MM. 2. ALL PIPE SIZES ARE IN MM. 3. FOR FLOOR PLANS AND DETAILS REFER DWG No. PS-BLOCK-A-TYP</p> <p>PROJECT PROPOSED RESIDENTIAL APARTMENTS "APARNA LAKE BREEZE" AT CHANDIA NAGAR, HYD.</p> <p>CLIENT M/s. APARNA CONSTRUCTIONS & ESTATES Pvt Ltd. HYDERABAD</p> <p>TITLE BLOCK-A-1 TYPICAL FLOOR PLAN ENLARGED TOILET DETAIL PLUMBING & SANITARY LAYOUT</p> <p>PRE CONTRACTOR M/s. SURENDRA PANIGRAHI BANGALORE</p> <p>ARCHITECT GENESIS PLANNERS PVT. LTD. ASSOCIATES PVT. LTD. 95/7 SWAMY COMPLEX 3rd Floor 24th Main 2nd Phase J.P. Nagar BANGALORE-560078 PIN NO. : 080-2646675/2658403 TELE FAX : 080-2646478 EMAIL : mail@genesisplannersassociates.com suresh@genesisplannersassociates.com www.genesisplannersassociates.com</p> <p>SCALE 1:25 DATE 05.02.2016 JOB NO. DRAWN DEALT</p> <p>CHECKED</p>			