





ABViewer 14 trial version - www.cadsofttools.com

LEGEND:	
SD	SOIL PIPE
WP	WASTE PIPE
BBWP	1100 BAN WATER PIPE
RWP	750 RAIN WATER PIPE
DW	DOMESTIC WATER SUPPLY PIPE
MWS	MUNICIPAL WATER SUPPLY PIPE
FWS	FLUSHING WATER SUPPLY PIPE
HDP	HDPE SOIL PIPE HEADER
1100D	1100 HDPE PIPE
1100H	1100 HDPE WASTE PIPE
750W	750 WASTE PIPE
EDC	1600 ECO DRAIN STRUCTURAL PIPE
SOD	SUB SOIL DRAINAGE PIPE
PRM	PUMP RISING MAIN
GT	GLASSY TRAP 450x450mm
IC	INSPECTION CHAMBER 600x600x750mm DEEP
IC-A	INSPECTION CHAMBER 1000x1000mm
MN-H	MANHOLE 1000x1000mm
BCP	BOTTOM CURE PIPE
EL	EMERGENCY LEVEL
CL	CONNECTING LEVEL
FGL	FINISHED GROUND LEVEL

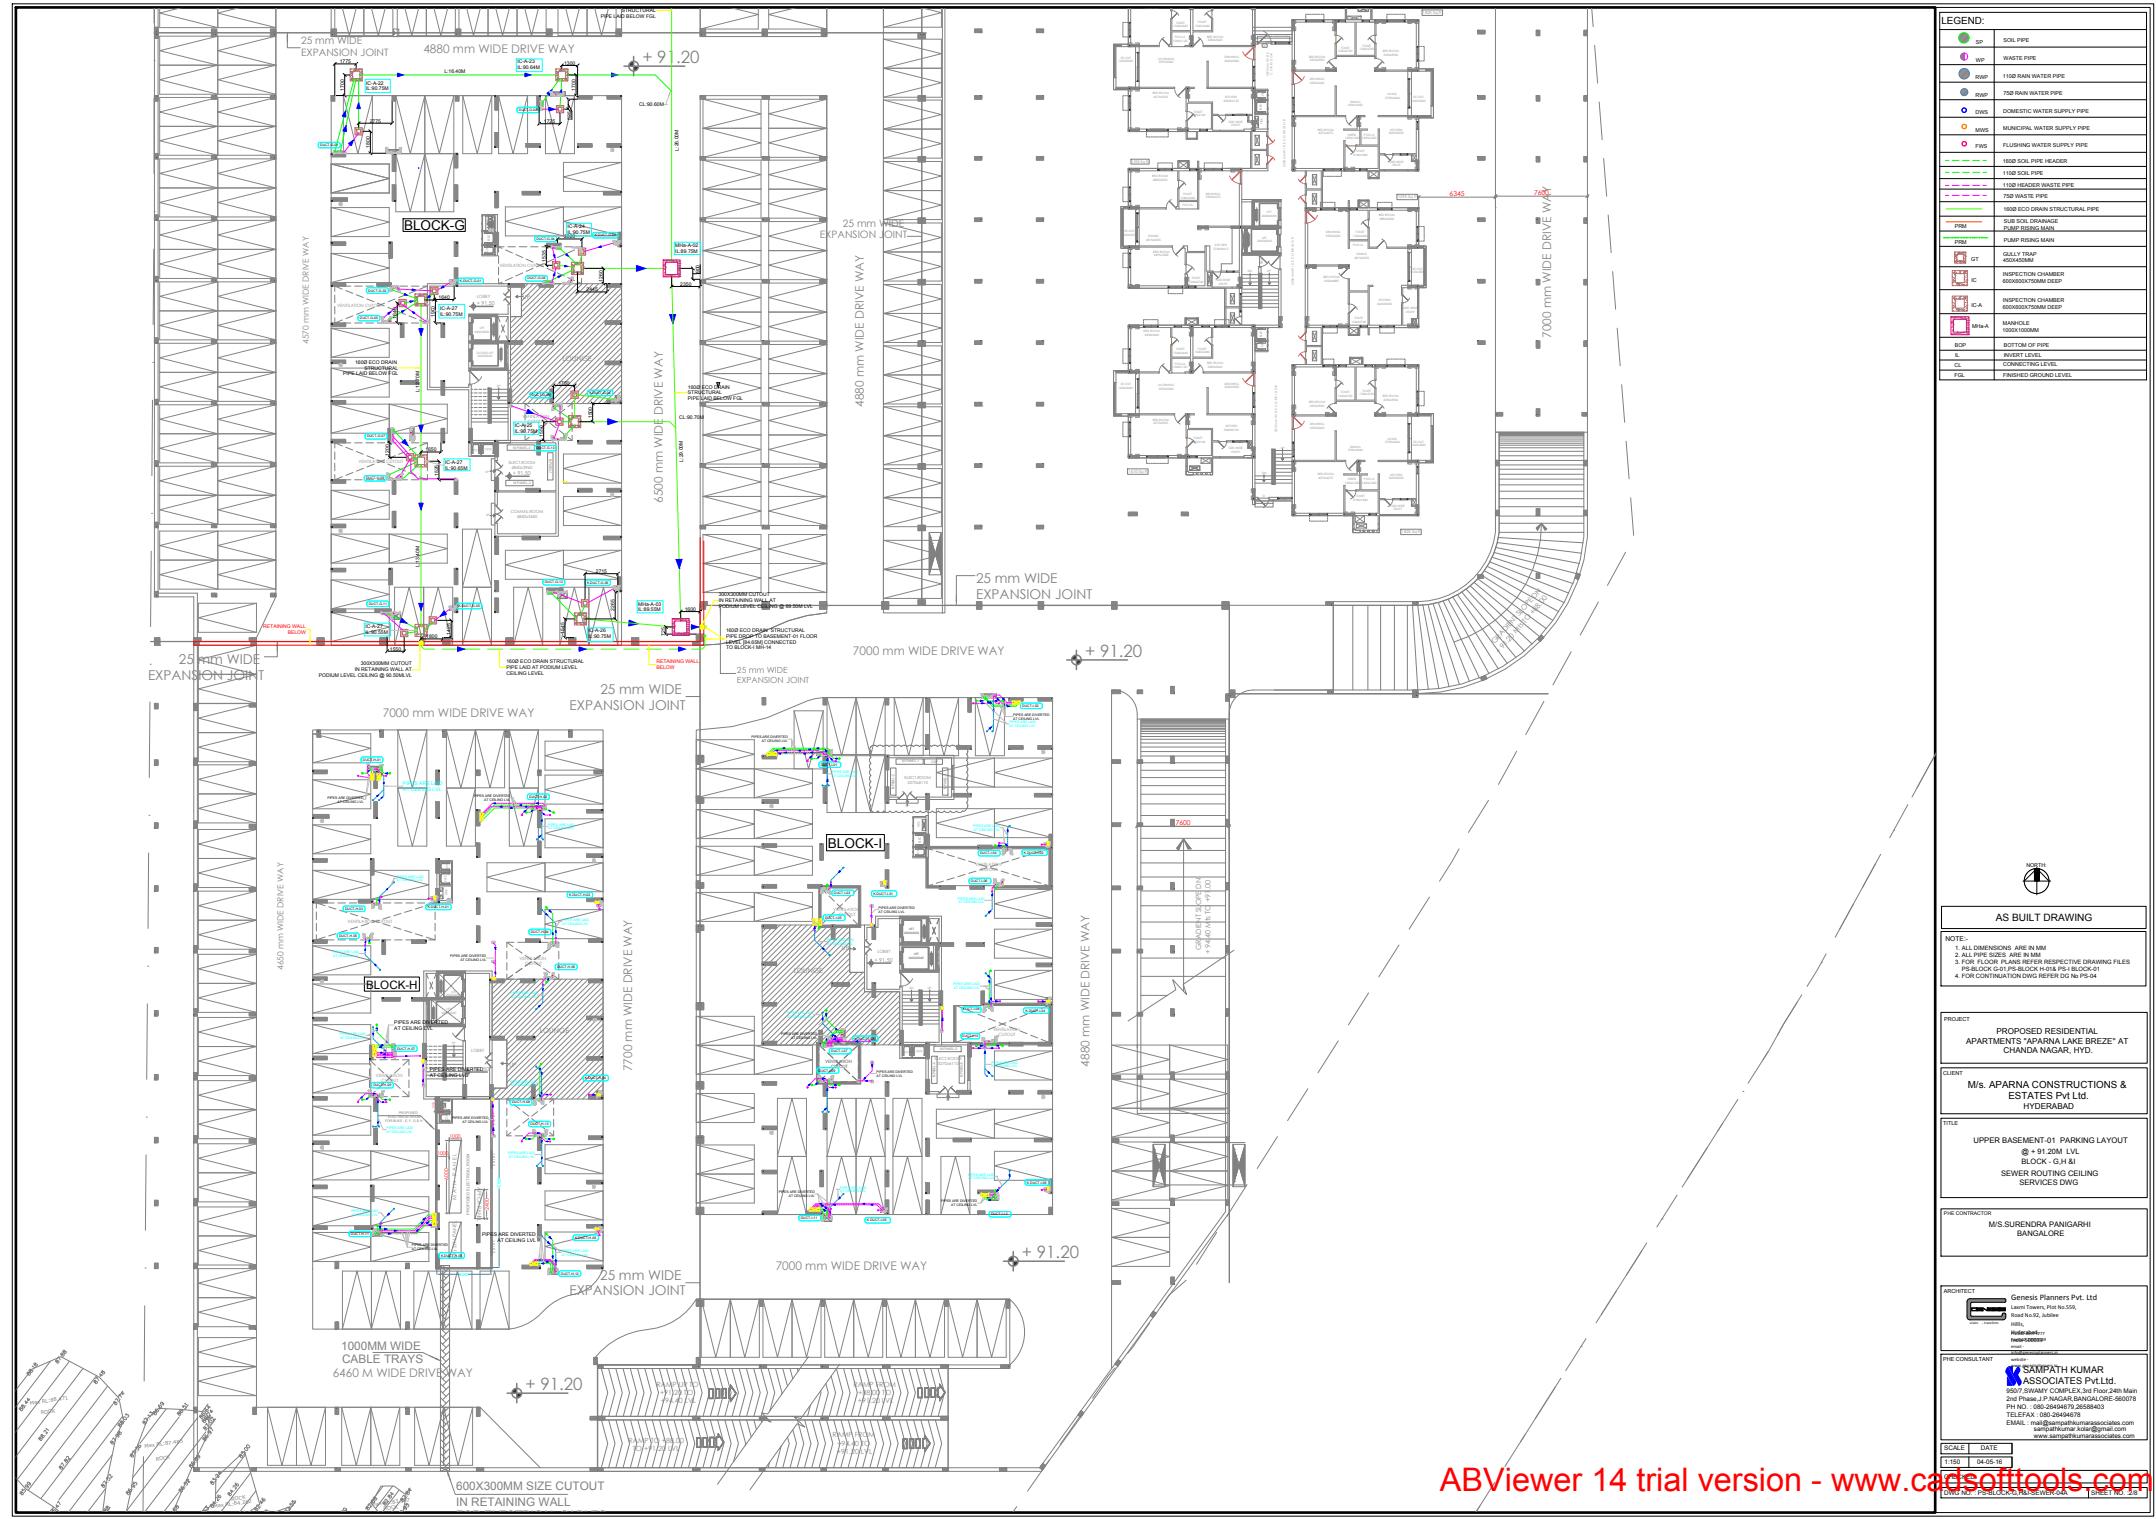

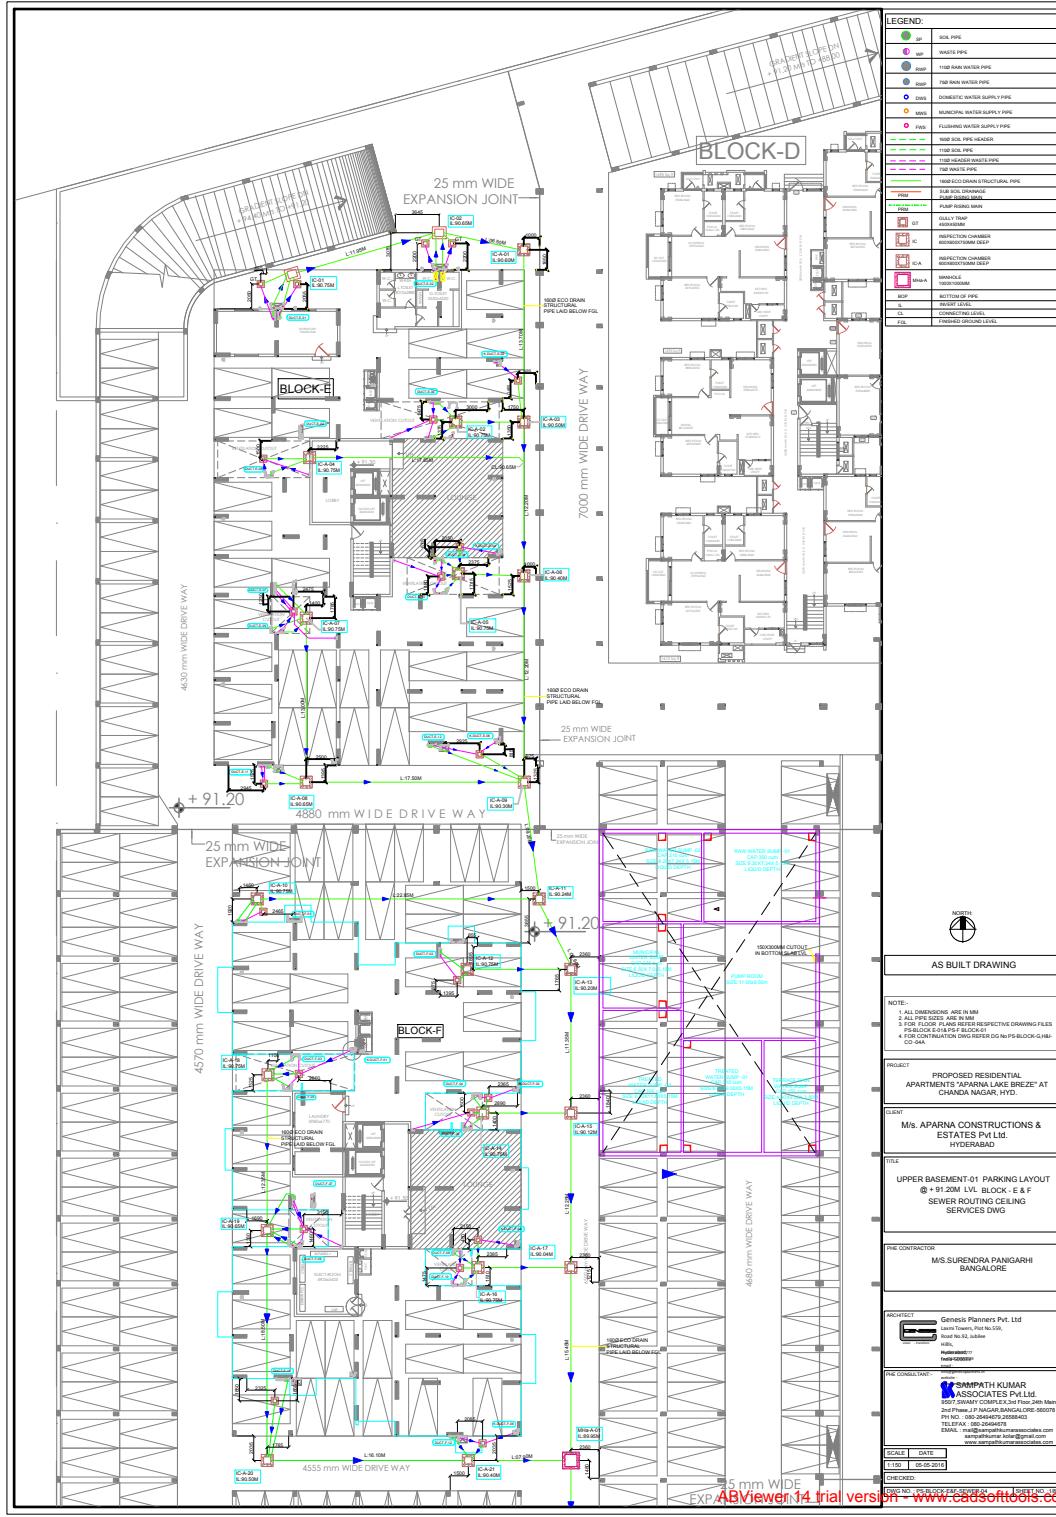

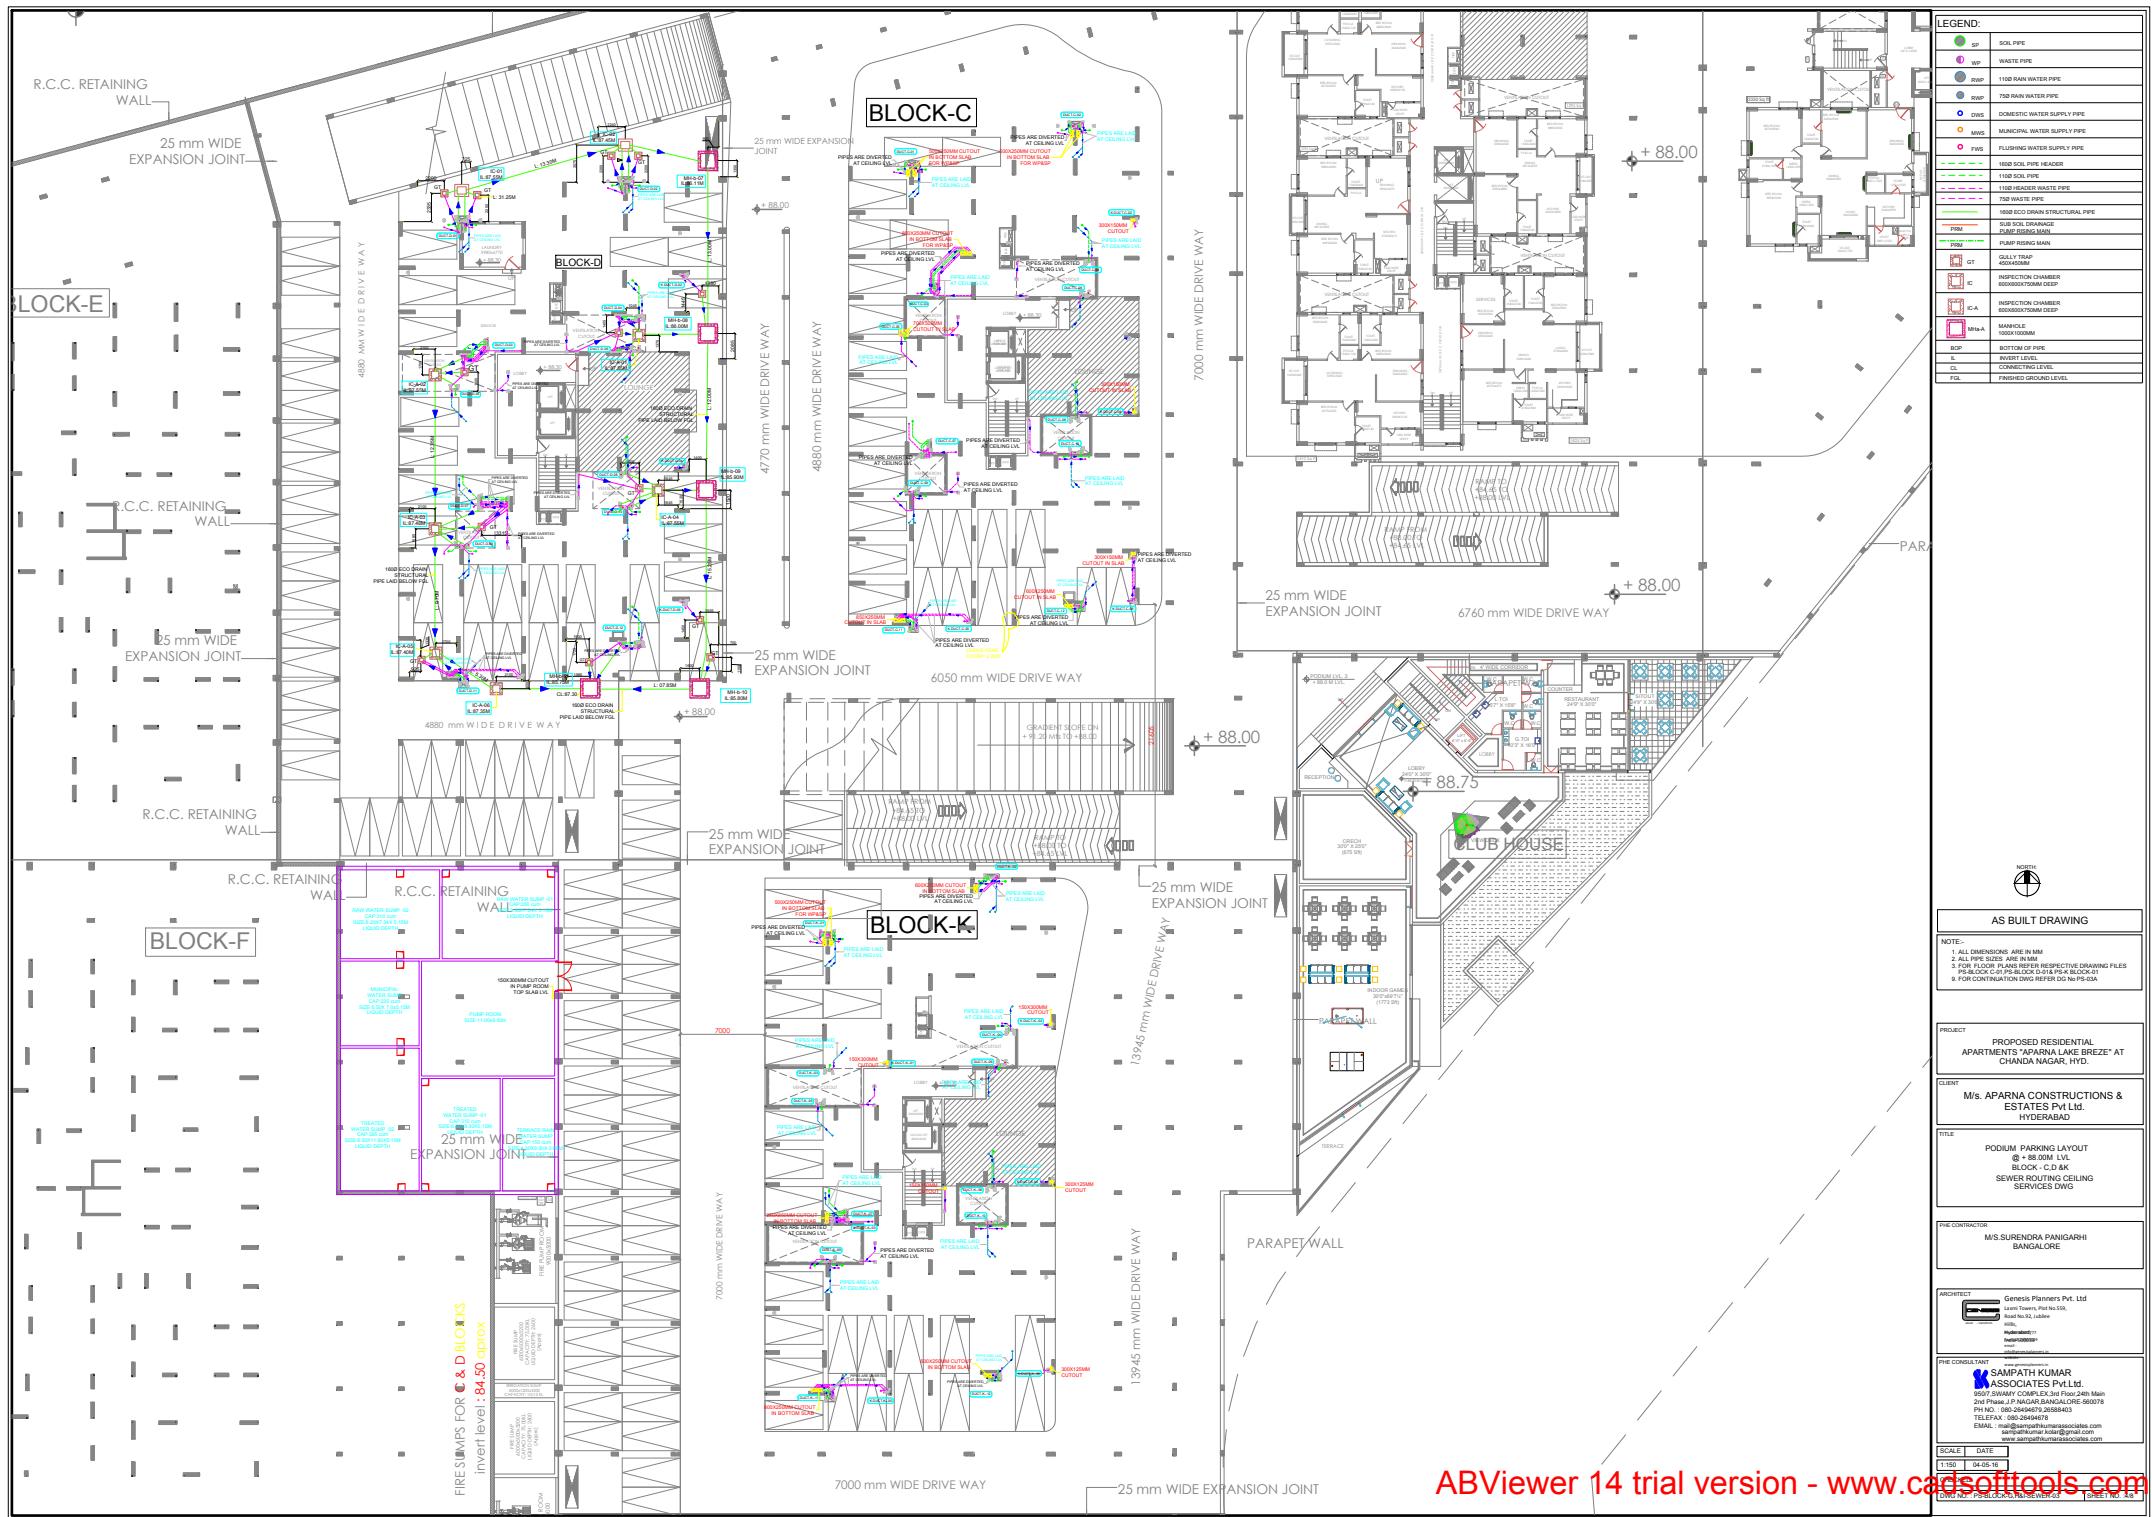

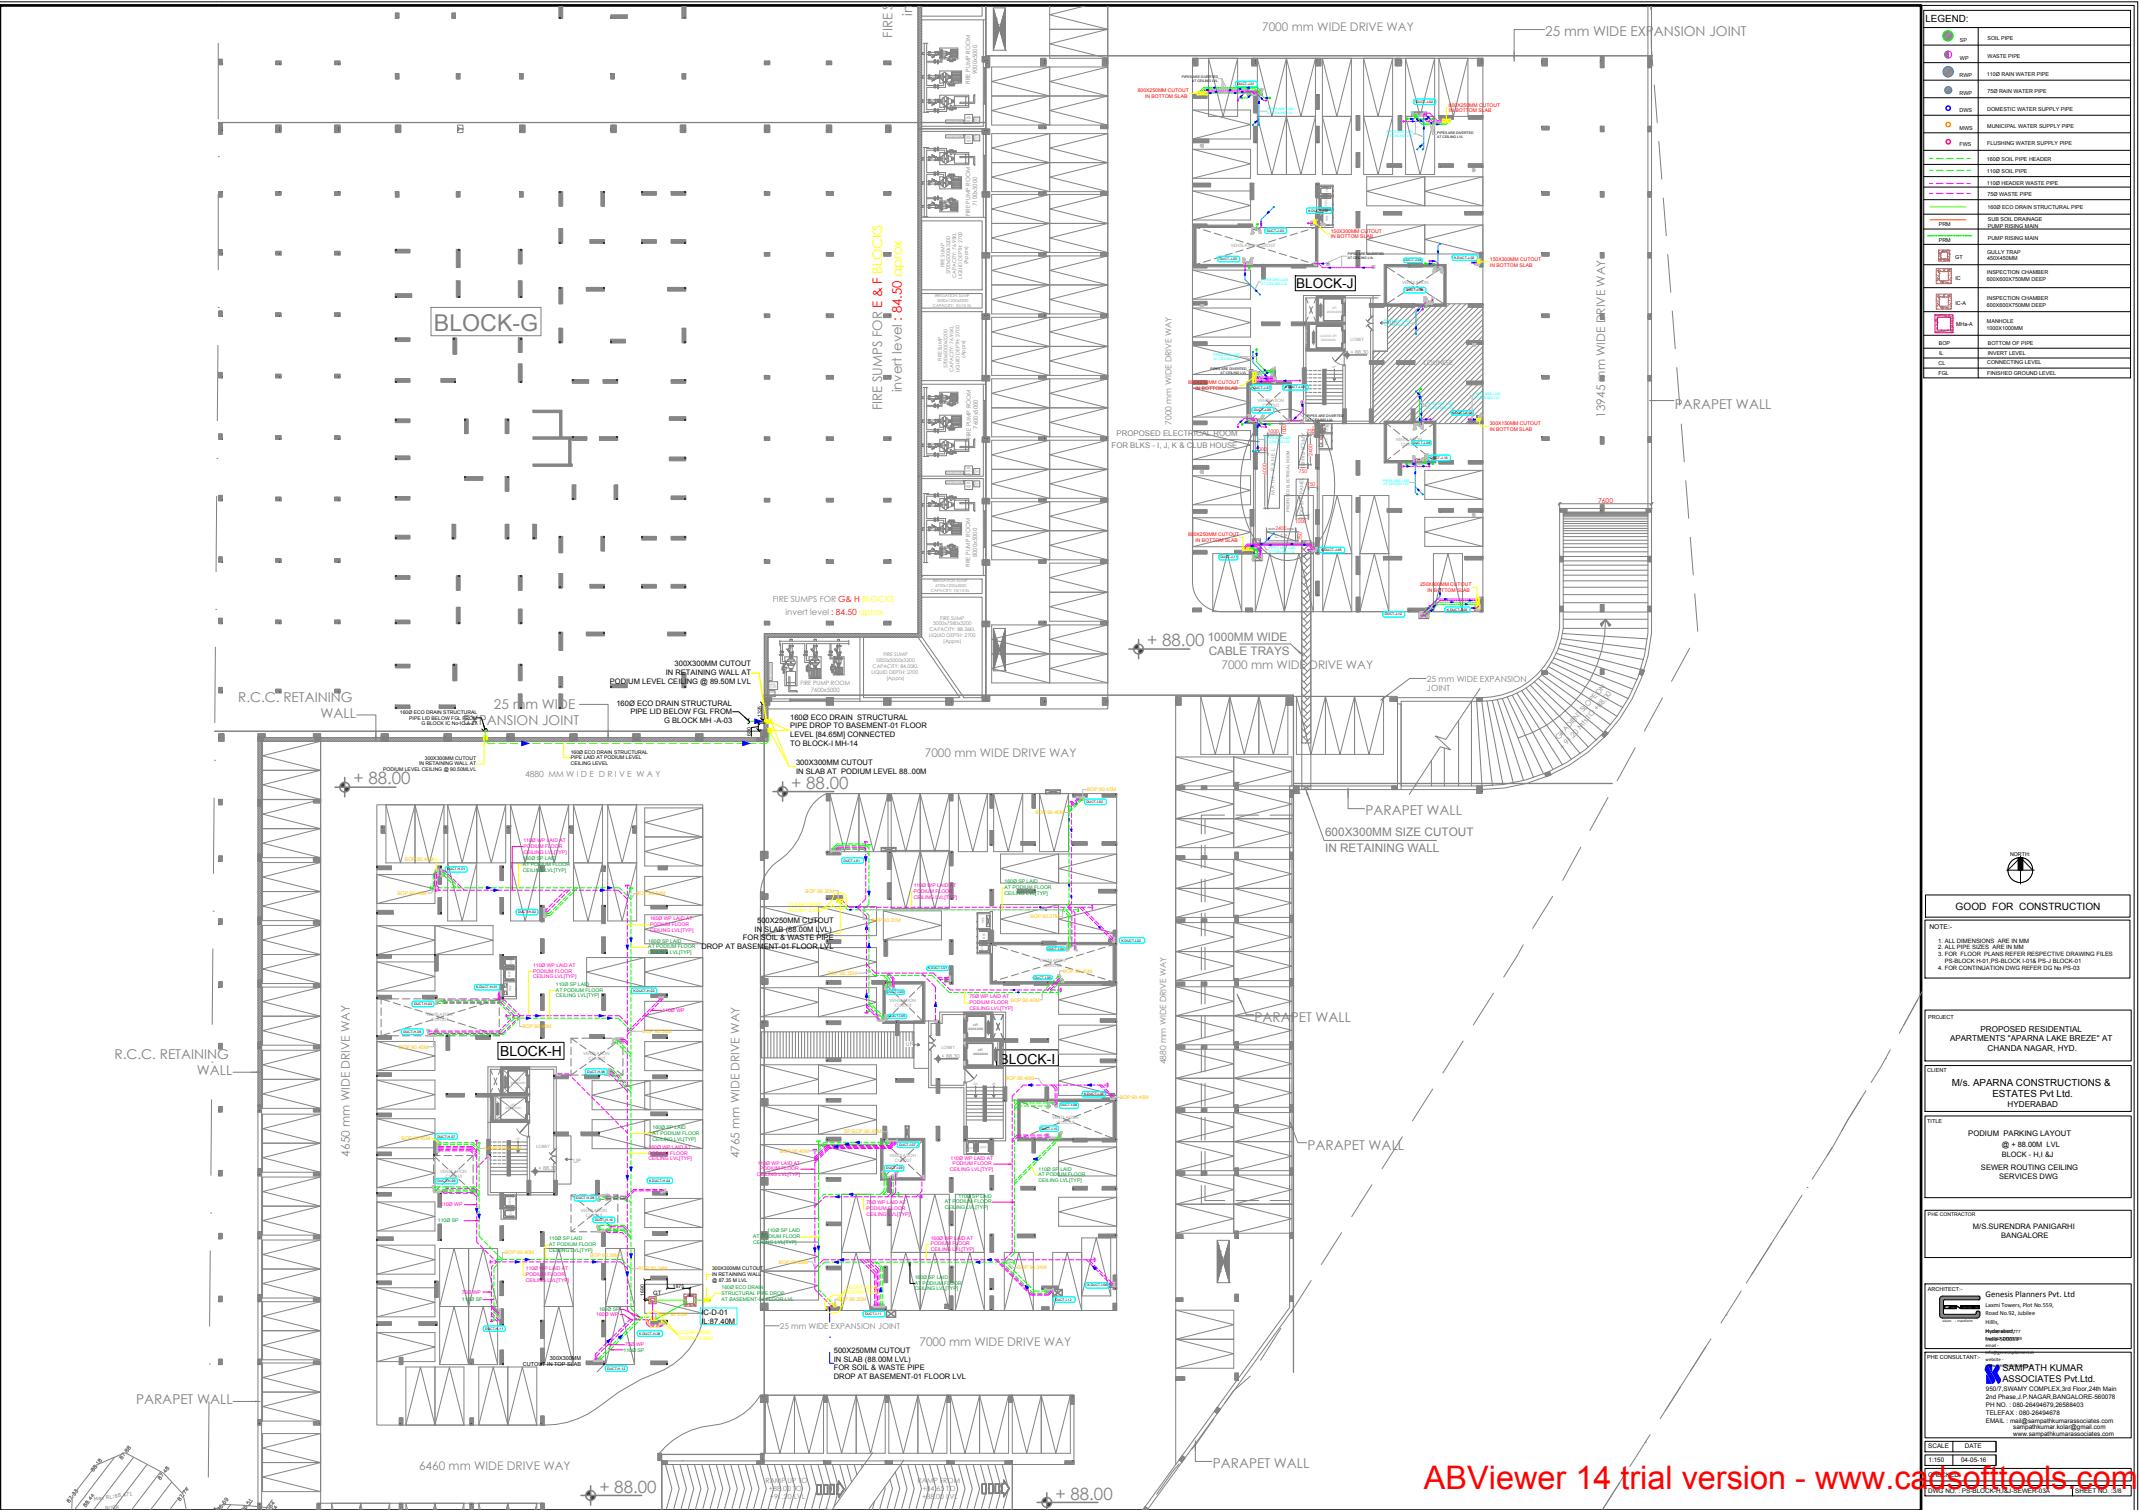

LEGEND:	
SD	SOIL PIPE
WP	WASTE PIPE
RWP	1100 RAIN WATER PIPE
RPW	750 RAIN WATER PIPE
DW	DOMESTIC WATER SUPPLY PIPE
MWS	MUNICIPAL WATER SUPPLY PIPE
FWS	FLUSHING WATER SUPPLY PIPE
SPW	SOIL PIPE HEADER
SDP	1100 SOIL PIPE
SWP	1100 HEADER WASTE PIPE
750W	750 WASTE PIPE
EDC	1600 EDC DRAIN STRUCTURAL PIPE
SOD	SUB SOIL DRAIN
PWM	PIPE WORK MANIFOLD
PWM	PUMP RISING MAIN
GT	GRILL TRAP
IC	INSPECTION CHAMBER 450x450mm
IC-A	INSPECTION CHAMBER 600x600x750mm DEEP
MNH	MANHOLE 1000x1000mm
BCP	BOTTOM CURE PIPE
CL	CONNECTING LEVEL
CL	CONNECTING LEVEL
FGL	FINISHED GROUND LEVEL

Elect
has



AS BUILT DRAWING

NOTE:-
 1. ALL DIMENSIONS ARE IN MM.
 2. ALL FLOOR PLANS REFER RESPECTIVE DRAWING FILES
 3. FOR FLOOR PLANS REFER PS-SQ-A2B
 4. FOR CONTINUATION DWG REFER DG NO PS-SQ-A2B

PROJECT PROPOSED RESIDENTIAL APARTMENTS "APARNA LAKE BREEZE" AT CHANDA NAGAR, HYD.

CLIENT M/s. APARNA CONSTRUCTIONS & ESTATES Pvt Ltd HYDERABAD

TITLE BASEMENT G1 PARKING LAYOUT
 • 84.6m LVL
 BLOCK - A & C
 SEWER ROUTING CEILING SERVICES DWG


PHV CONTRACTOR M.SURENDRA PANIGARHI BANGALORE

ARCHITECT Genesis Planners Pvt. Ltd
 Plot No. 10, Jyoti Residency,
 Road No. 32, Jyoti
 Hills, Hyderabad - 500084
 India +91 9849000001

PH CONSULTANT SAMPATH KUMAR
 SAMPATH KUMAR Pvt. Ltd.
 9207 SWARAJ COMPLEX, 3rd Floor, 24th Main
 Road, Opp. P. J. P. High School, Sec-56/78
 PH NO. 066-2446479, 988588403
 MOBILE NO. 9849000001
 EMAIL: mail@sampathkumarassociates.com
 www.sampathkumarassociates.com

SCALE DATE
 1:150 04-04-14

DWG NO. P-20140404-00001
 Sheet No. 1 of 1

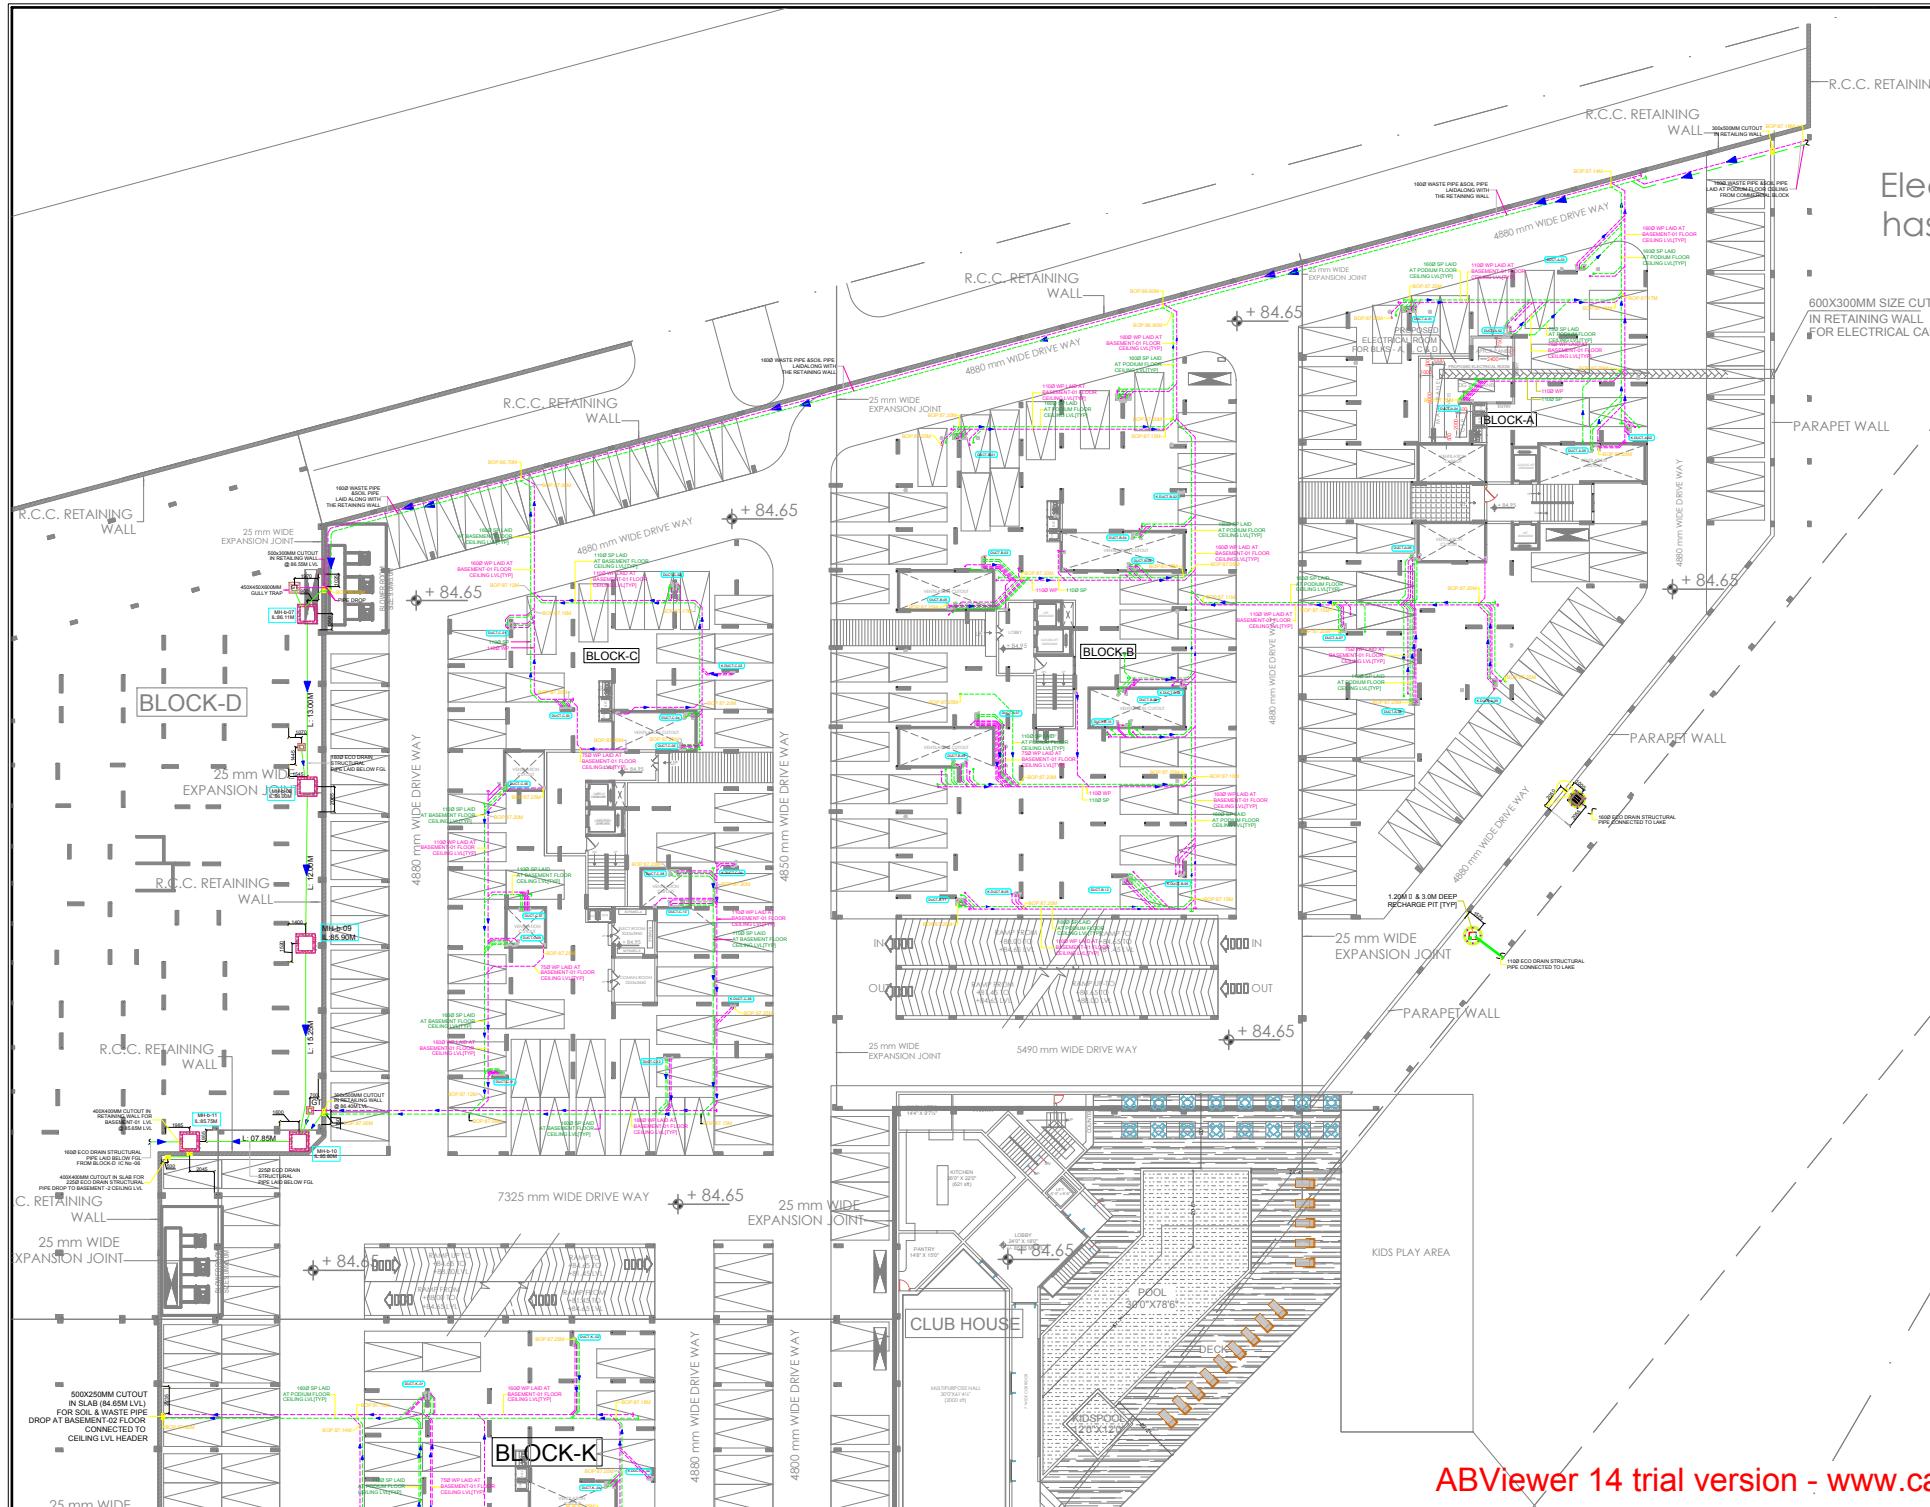

LEGEND:	
	SOIL PIPE
	WASTE PIPE
	1100 RAIN WATER PIPE
	750 RAIN WATER PIPE
	DW
	MWS
	HDP
	HWP
	1600 ECO DRAIN STRUCTURAL PIPE
	1600 SUB SOIL DRAINAGE PIPE
	PRM
	IPM
	IC-A
	MANHOLE
	BOP
	ML
	CL
	FGL

