


ABViewer 14 trial version - www.cadsofttools.com

KEY PLAN

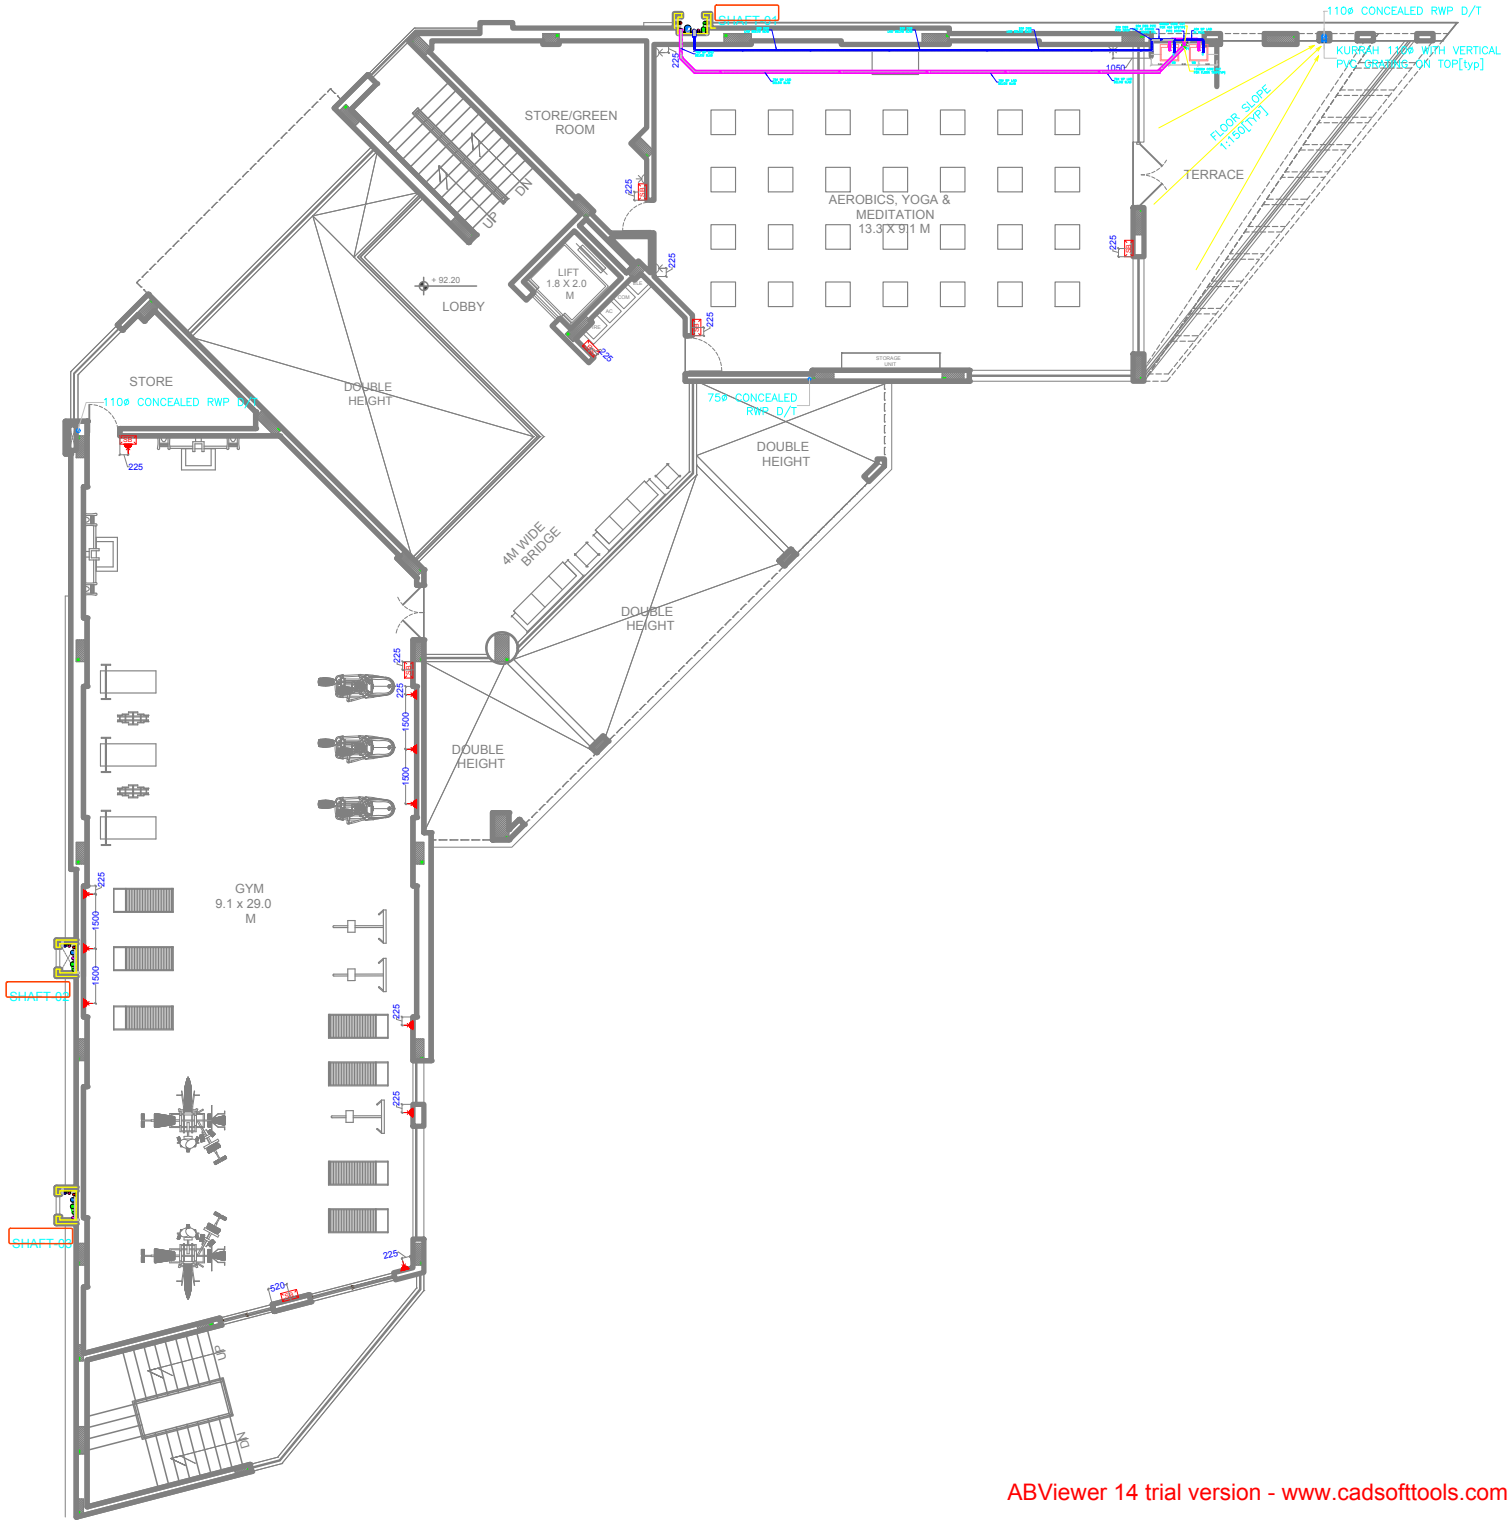


ORIENTATION:

N
W E
S

NOTES :
1. ALL DIMENSIONS ARE IN MM UNLESS OTHERWISE SPECIFIED.
2. DO NOT SCALE THE DRAWING REFER TO DIMENSIONS AS INDICATED.

AS BUILT DRAWING

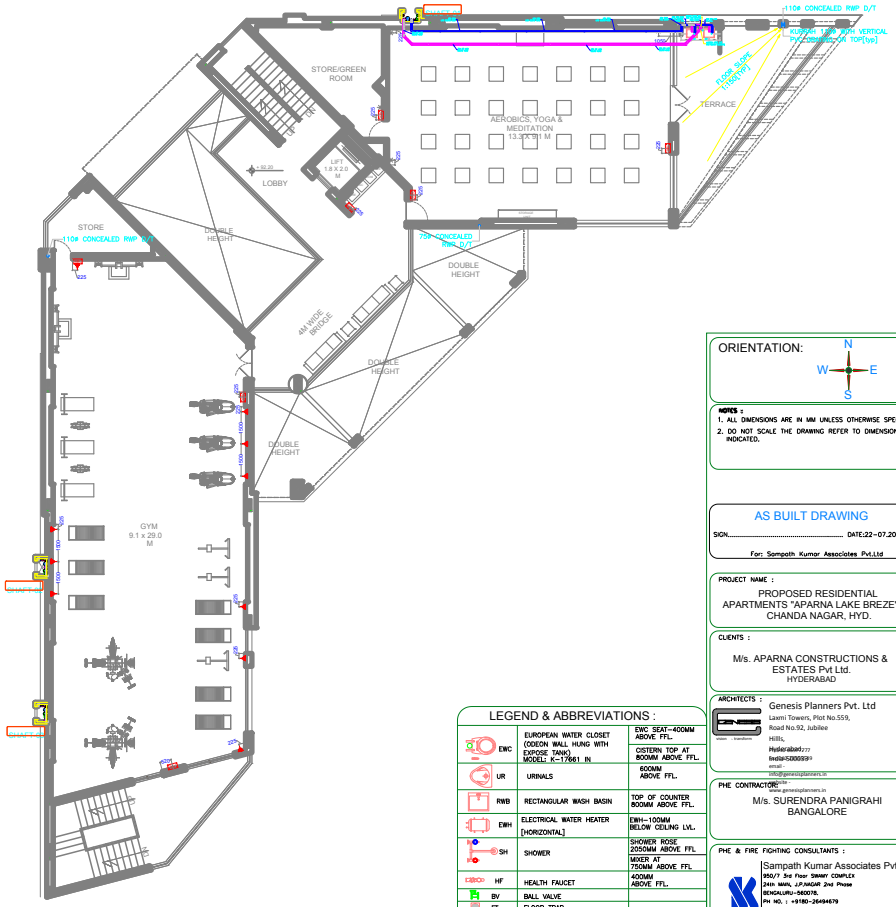SIGN..... DATE:22-07.2016

For: Sampath Kumar Associates Pvt.Ltd

PROJECT NAME :

PROPOSED RESIDENTIAL APARTMENTS "APARNA LAKE BREZE" AT CHANDA NAGAR, HYD.

CLIENTS :

M/s. APARNA CONSTRUCTIONS & ESTATES Pvt Ltd.
HYDERABAD

ARCHITECTS :

Genesis Planners Pvt. Ltd
Laxmi Towers, Plot No.559,
Road No.92, Jubilee
Hills,
Hyderabad-
India-500033
email :
info@genesisplanners.in
website :
www.genesisplanners.in

PHE CONTRACTOR :

M/s. SURENDRA PANIGRAHI
BANGALORE

PHE & FIRE FIGHTING CONSULTANTS :

Sampath Kumar Associates Pvt.Ltd
360/7 3rd Floor SMMV COMPLEX
24th MAIN, J.P.NAGAR 2nd Phase
BENGALURU-560078.
Ph NO. : +9180-26694679
EMAIL : ms@sampathkumarassociates.com
sampathkumar.sales@gmail.com
Web Site : sampathkumarassociates.com

PURPOSE :

AS BUILT DRAWING

DRAWING TITLE :

CLUB HOUSE
FIRST FLOOR PLAN
PLUMBING & SANITARY SYSTEM

DRAWING NO : PS-04

| | |
|---|---|
| DRAWN : | DATE: 22.07.2016 |
| DESIGNED : | SCALE : 1:100 |
| APPROVED : | SHEET : 4 OF 5 |
| JOB NO : | |

## LEGEND & ABBREVIATIONS :

| | | |
|---|---|---|
| EWC | EUROPEAN WATER CLOSET (CODEON WALL HUNG WITH EXPOSE TANK) MODEL: K-17661 IN | EWC SEAT-400MM ABOVE FFL. CISTERN TOP AT 800MM ABOVE FFL. |
| UR | URINALS | 600MM ABOVE FFL. |
| RWB | RECTANGULAR WASH BASIN | TOP OF COUNTER 800MM ABOVE FFL. |
| EWH | ELECTRICAL WATER HEATER [HORIZONTAL] | EWH-100MM BELOW CEILING LVL. |
| SH | SHOWER | SHOWER ROSE 2050MM ABOVE FFL MIXER AT 750MM ABOVE FFL |
| HF | HEALTH FAUCET | 400MM ABOVE FFL. |
| BV | BALL VALVE | |
| FT | FLOOR TRAP | |
| KS | KITCHEN SINK | TOP OF COUNTER 800MM ABOVE FFL. |
| | SHOWER SPOUT | 750MM ABOVE FFL. |
| DWS | DOMESTIC WATER SUPPLY INTERNAL PIPES PPR. | |
| FWS | FLUSHING WATER SUPPLY INTERNAL PIPES PPR. | |
| HWS | HOT WATER SUPPLY INTERNAL PIPES PPR. | |
| DWS | DOMESTIC WATER SUPPLY GJ PIPES INSIDE THE DUCTS: PPR PIPES INSIDE THE TOILET: | |
| FWS | FLUSHING WATER SUPPLY GJ PIPES INSIDE THE DUCTS: PPR PIPES INSIDE THE TOILET: | |
| FFL | FINISHED FLOOR LEVEL | |
| FGL | FINISHED GROUND LEVEL | |
| IL | INVERT LEVEL | |

ABViewer 14 trial version - www.cadsofttools.com