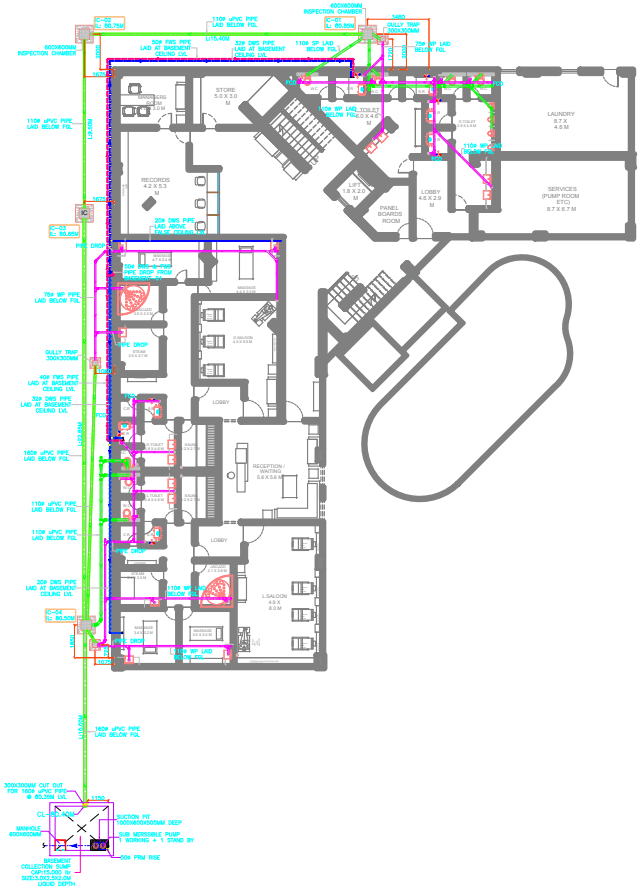

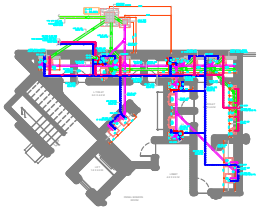

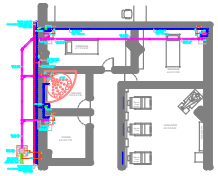

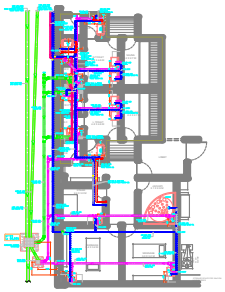

ABViewer 14 trial version - www.cadsofttools.com

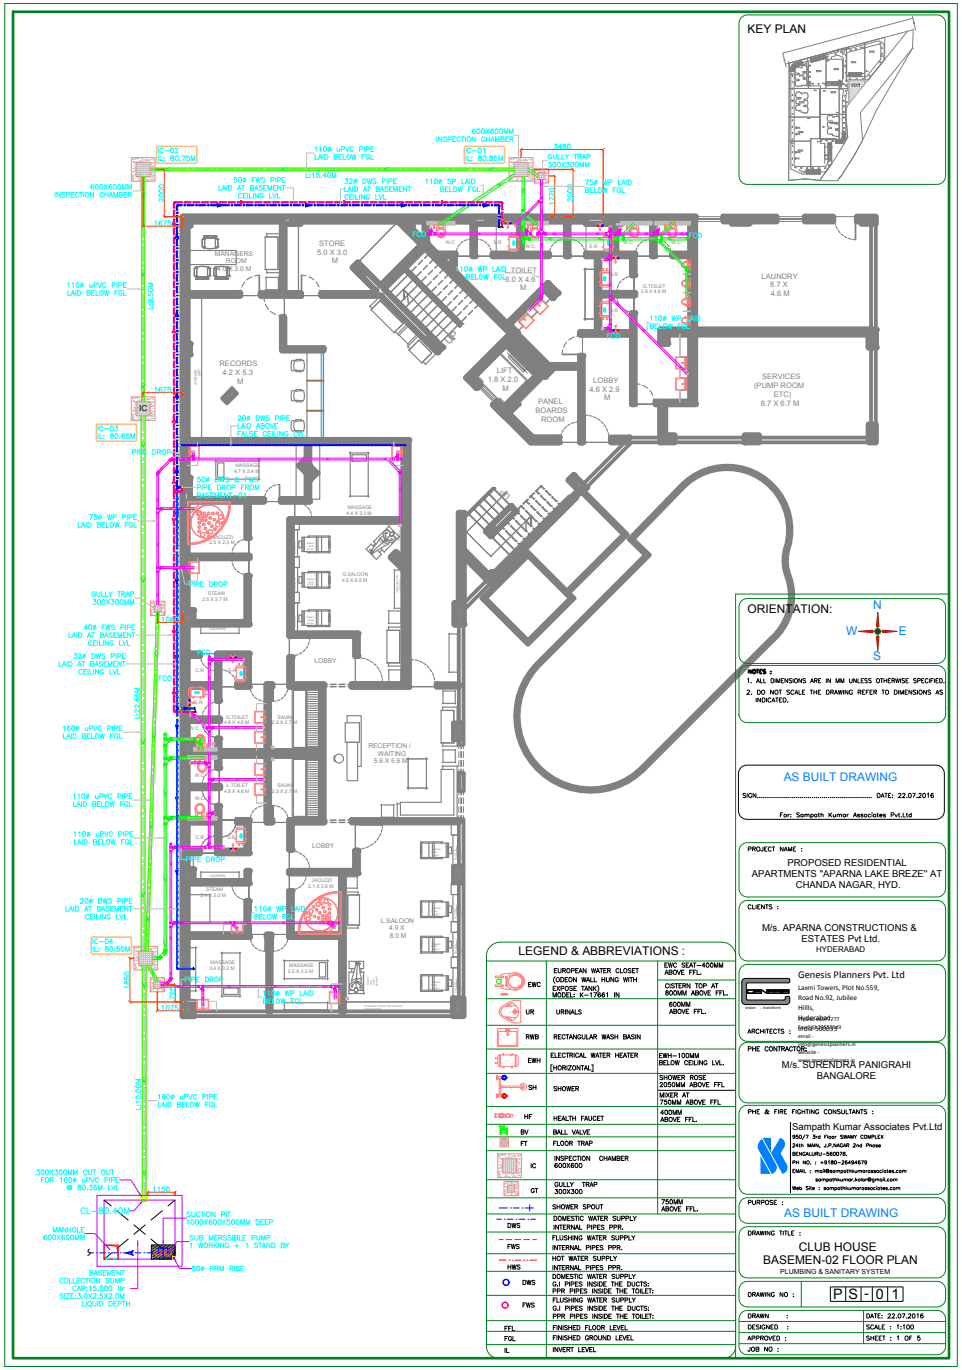

LEGEND & ABBREVIATIONS :

EWC	EUROPEAN WATER CLOSET (CODECM WALL HUNG WITH EXPOSE TANK) MODEL: K-17661 IN	EWC SEAT-400MM ABOVE FFL. CISTERN TOP AT 800MM ABOVE FFL.
UR	URINALS	600MM ABOVE FFL.
RWB	RECTANGULAR WASH BASIN	
EWH	ELECTRICAL WATER HEATER [HORIZONTAL]	EWH-100MM BELOW CEILING LVL.
SH	SHOWER	SHOWER ROSE 2050MM ABOVE FFL MIXER AT 750MM ABOVE FFL
HF	HEALTH FAUCET	400MM ABOVE FFL.
BV	BALL VALVE	
FT	FLOOR TRAP	
IC	INSPECTION CHAMBER 600X600	
GT	GULLY TRAP 300X300	
	SHOWER SPOUT	750MM ABOVE FFL.
DWS	DOMESTIC WATER SUPPLY INTERNAL PIPES PPR.	
FWS	FLUSHING WATER SUPPLY INTERNAL PIPES PPR.	
HWS	HOT WATER SUPPLY INTERNAL PIPES PPR.	
DWS	DOMESTIC WATER SUPPLY GJ PIPES INSIDE THE DUCTS: PPR PIPES INSIDE THE TOILET:	
FWS	FLUSHING WATER SUPPLY GJ PIPES INSIDE THE DUCTS: PPR PIPES INSIDE THE TOILET:	
FFL	FINISHED FLOOR LEVEL	
FGL	FINISHED GROUND LEVEL	
IL	INVERT LEVEL	

ABViewer 14 trial version - www.cadsofttools.com

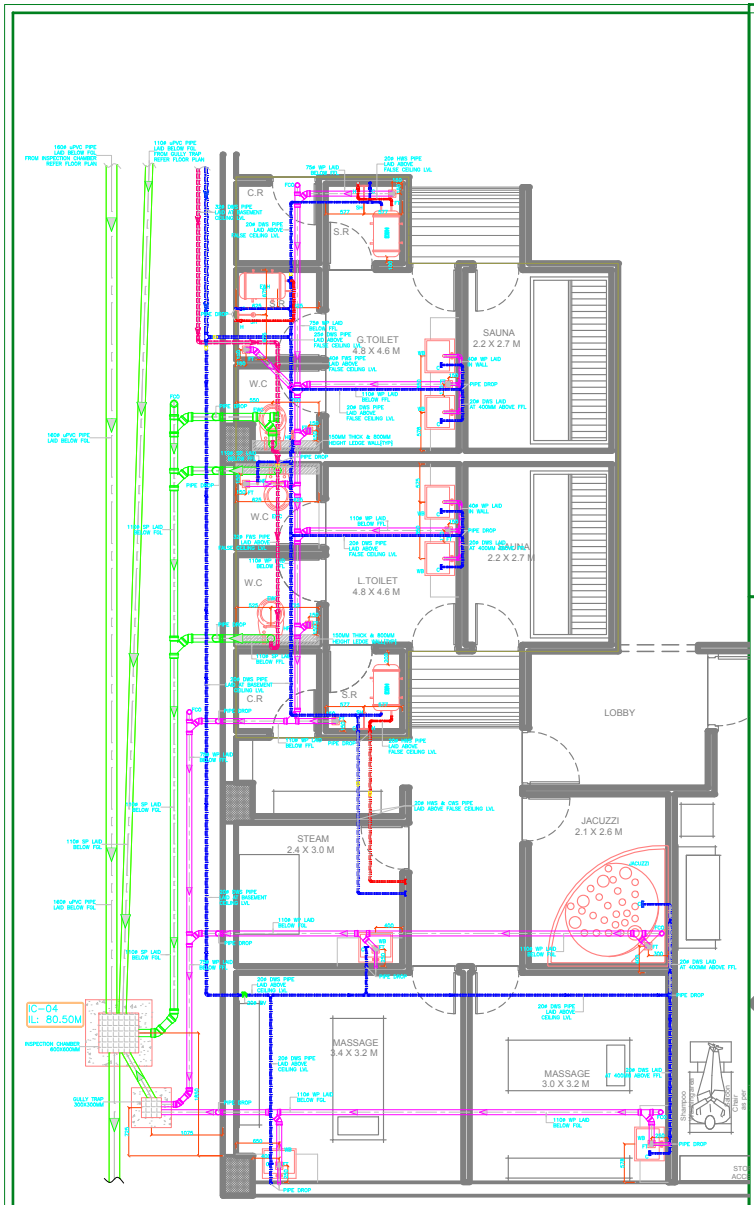

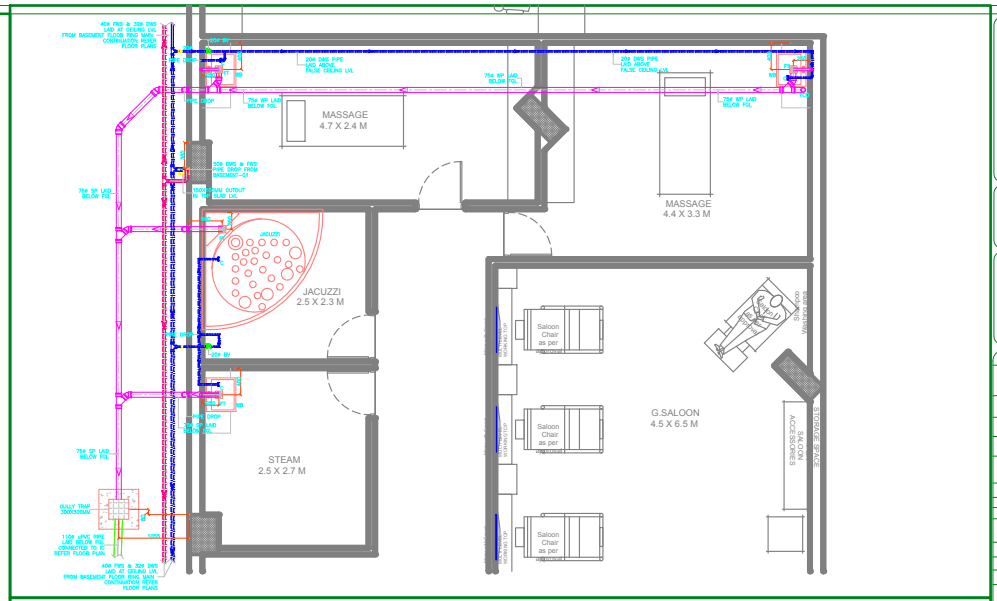

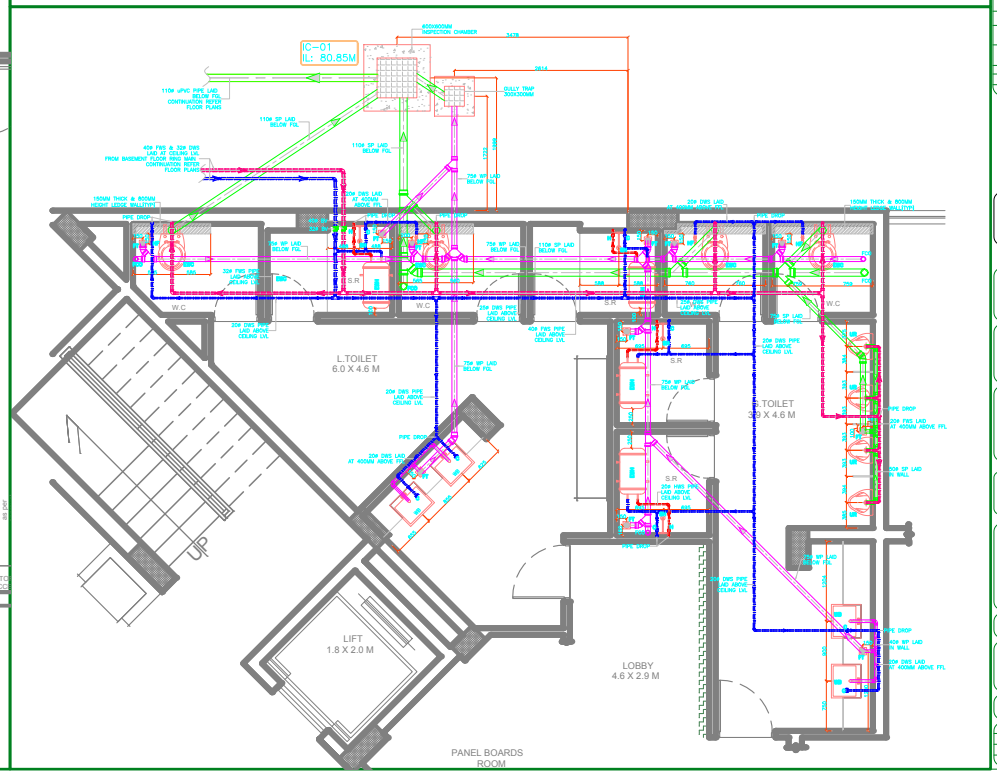

KEY PLAN

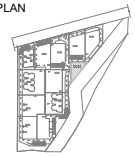

ORIENTATION:

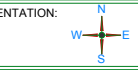

NOTES :
1. ALL DIMENSIONS ARE IN MM UNLESS OTHERWISE SPECIFIED.

LEGEND & ABBREVIATIONS :

	EWC	EUROPEAN WATER CLOSET (CODION WALL HUNG WITH EXPOSE TANK) MODEL: K-17961 IN	EWC SEAT-450MM ABOVE FFL. CISTERN TOP AT 800MM ABOVE FFL.
	UR	URINALS	600MM ABOVE FFL.
	RWB	RECTANGULAR WASH BASIN	
	EWH	ELECTRICAL WATER HEATER (HORIZONTAL)	EWH-100MM BELOW CEILING LVL.
	SH	SHOWER	SHOWER ROSE 2050MM ABOVE FFL MIXER AT 750MM ABOVE FFL
	HF	HEALTH FAUCET	400MM ABOVE FFL.
	BV	BALL VALVE	
	FT	FLOOR TRAP	
	IC	INSPECTION CHAMBER 600X600	
	GT	GULLY TRAP 300X300	
		SHOWER SPOUT	750MM ABOVE FFL.
	DWS	DOMESTIC WATER SUPPLY INTERNAL PIPES PPR.	
	FWS	FLUSHING WATER SUPPLY INTERNAL PIPES PPR.	
	HWS	HOT WATER SUPPLY INTERNAL PIPES PPR.	
	DWS	DOMESTIC WATER SUPPLY GJ PIPES INSIDE THE DUCTS; PPR PIPES INSIDE THE TOILET;	
	FWS	FLUSHING WATER SUPPLY GJ PIPES INSIDE THE DUCTS; PPR PIPES INSIDE THE TOILET;	
	FFL	FINISHED FLOOR LEVEL	
	FGL	FINISHED GROUND LEVEL	
	IL	INVERT LEVEL	

AS BUILT DRAWING

SIGN..... DATE:22-07-2016

For: Sampath Kumar Associates Pvt.Ltd

PROJECT NAME :

PROPOSED RESIDENTIAL APARTMENTS "APARNA LAKE BREZE" AT CHANDA NAGAR, HYD.

CLIENTS :

M/s. APARNA CONSTRUCTIONS & ESTATES Pvt Ltd.
HYDERABAD.

ARCHITECTS :

Genesis Planners Pvt. Ltd
Laxmi Towers, Plot No.559,
Road No.92, Jubilee
Hills,
Hyderabad-
Pin:500033
email:
info@genesisplanners.net
website :
www.genesisplanners.in

PHE CONTRACTOR:

M/s. SURENDRA PANIGRAHI
BANGALORE

PHE & FIRE FIGHTING CONSULTANTS :

Sampath Kumar Associates Pvt.Ltd
#90/7 3rd Floor SWAMY COMPLEX
24th MAIN, J.P.NAGAR 2nd Phase
BENGALURU-560078.
Ph NO. : +9180-26494679
EMAIL : mail@sampathkumarassociates.com
sampathkumar.kdar@gmail.com
Web Site : sampathkumarassociates.com

PURPOSE :

AS BUILT DRAWING

DRAWING TITLE :

BASEMENT-2 FLOOR
ENLARGED TOILET DETAIL
PLUMBING SERVICES LAYOUT

DRAWING NO : PS-ETD-01

DRAWN :	DATE: 22.07.2016
DESIGNED :	SCALE : 1:25
APPROVED :	SHEET : 1 OF 3
JOB NO :	

ABViewer 14 trial version - www.cadsofttools.com